


AS-BUILT DRAWINGS HAVE BEEN  
MODIFIED PER CONTRACTOR  
MARKUPS RECEIVED ON

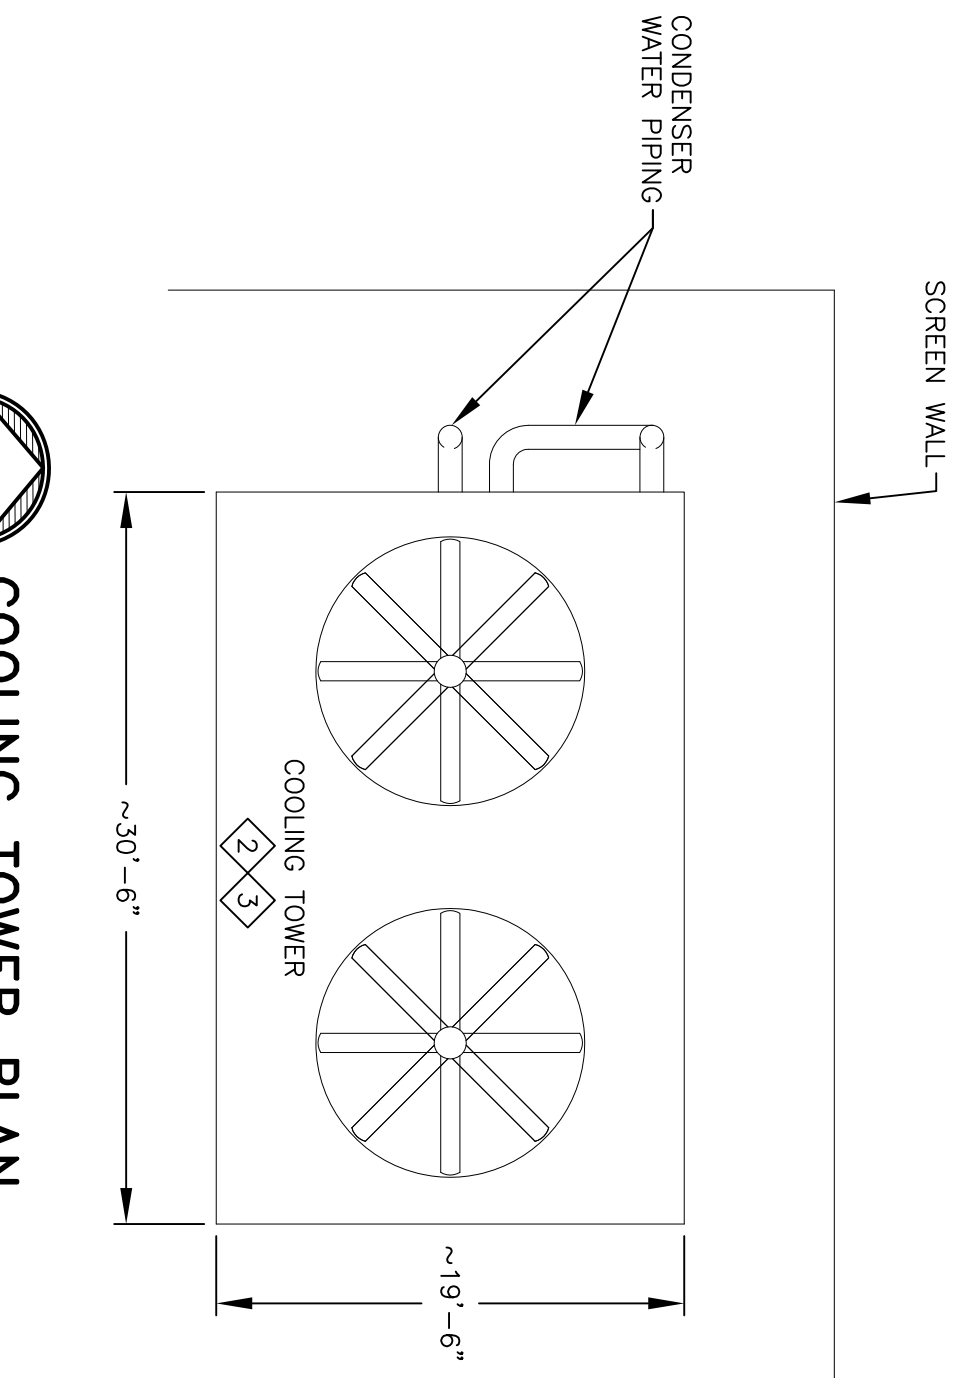

COOLING TOWER PLAN

SCALE: 1/8" = 1'-0"


HOT  
WATER  
PUMP  
NO. 1

HOT  
WATER  
PUMP  
NO. 2

HOT  
WATER  
PUMP  
NO. 3

STEAM/WATER HEAT EXCHANGER NO. 1 & 2

EXPANSION

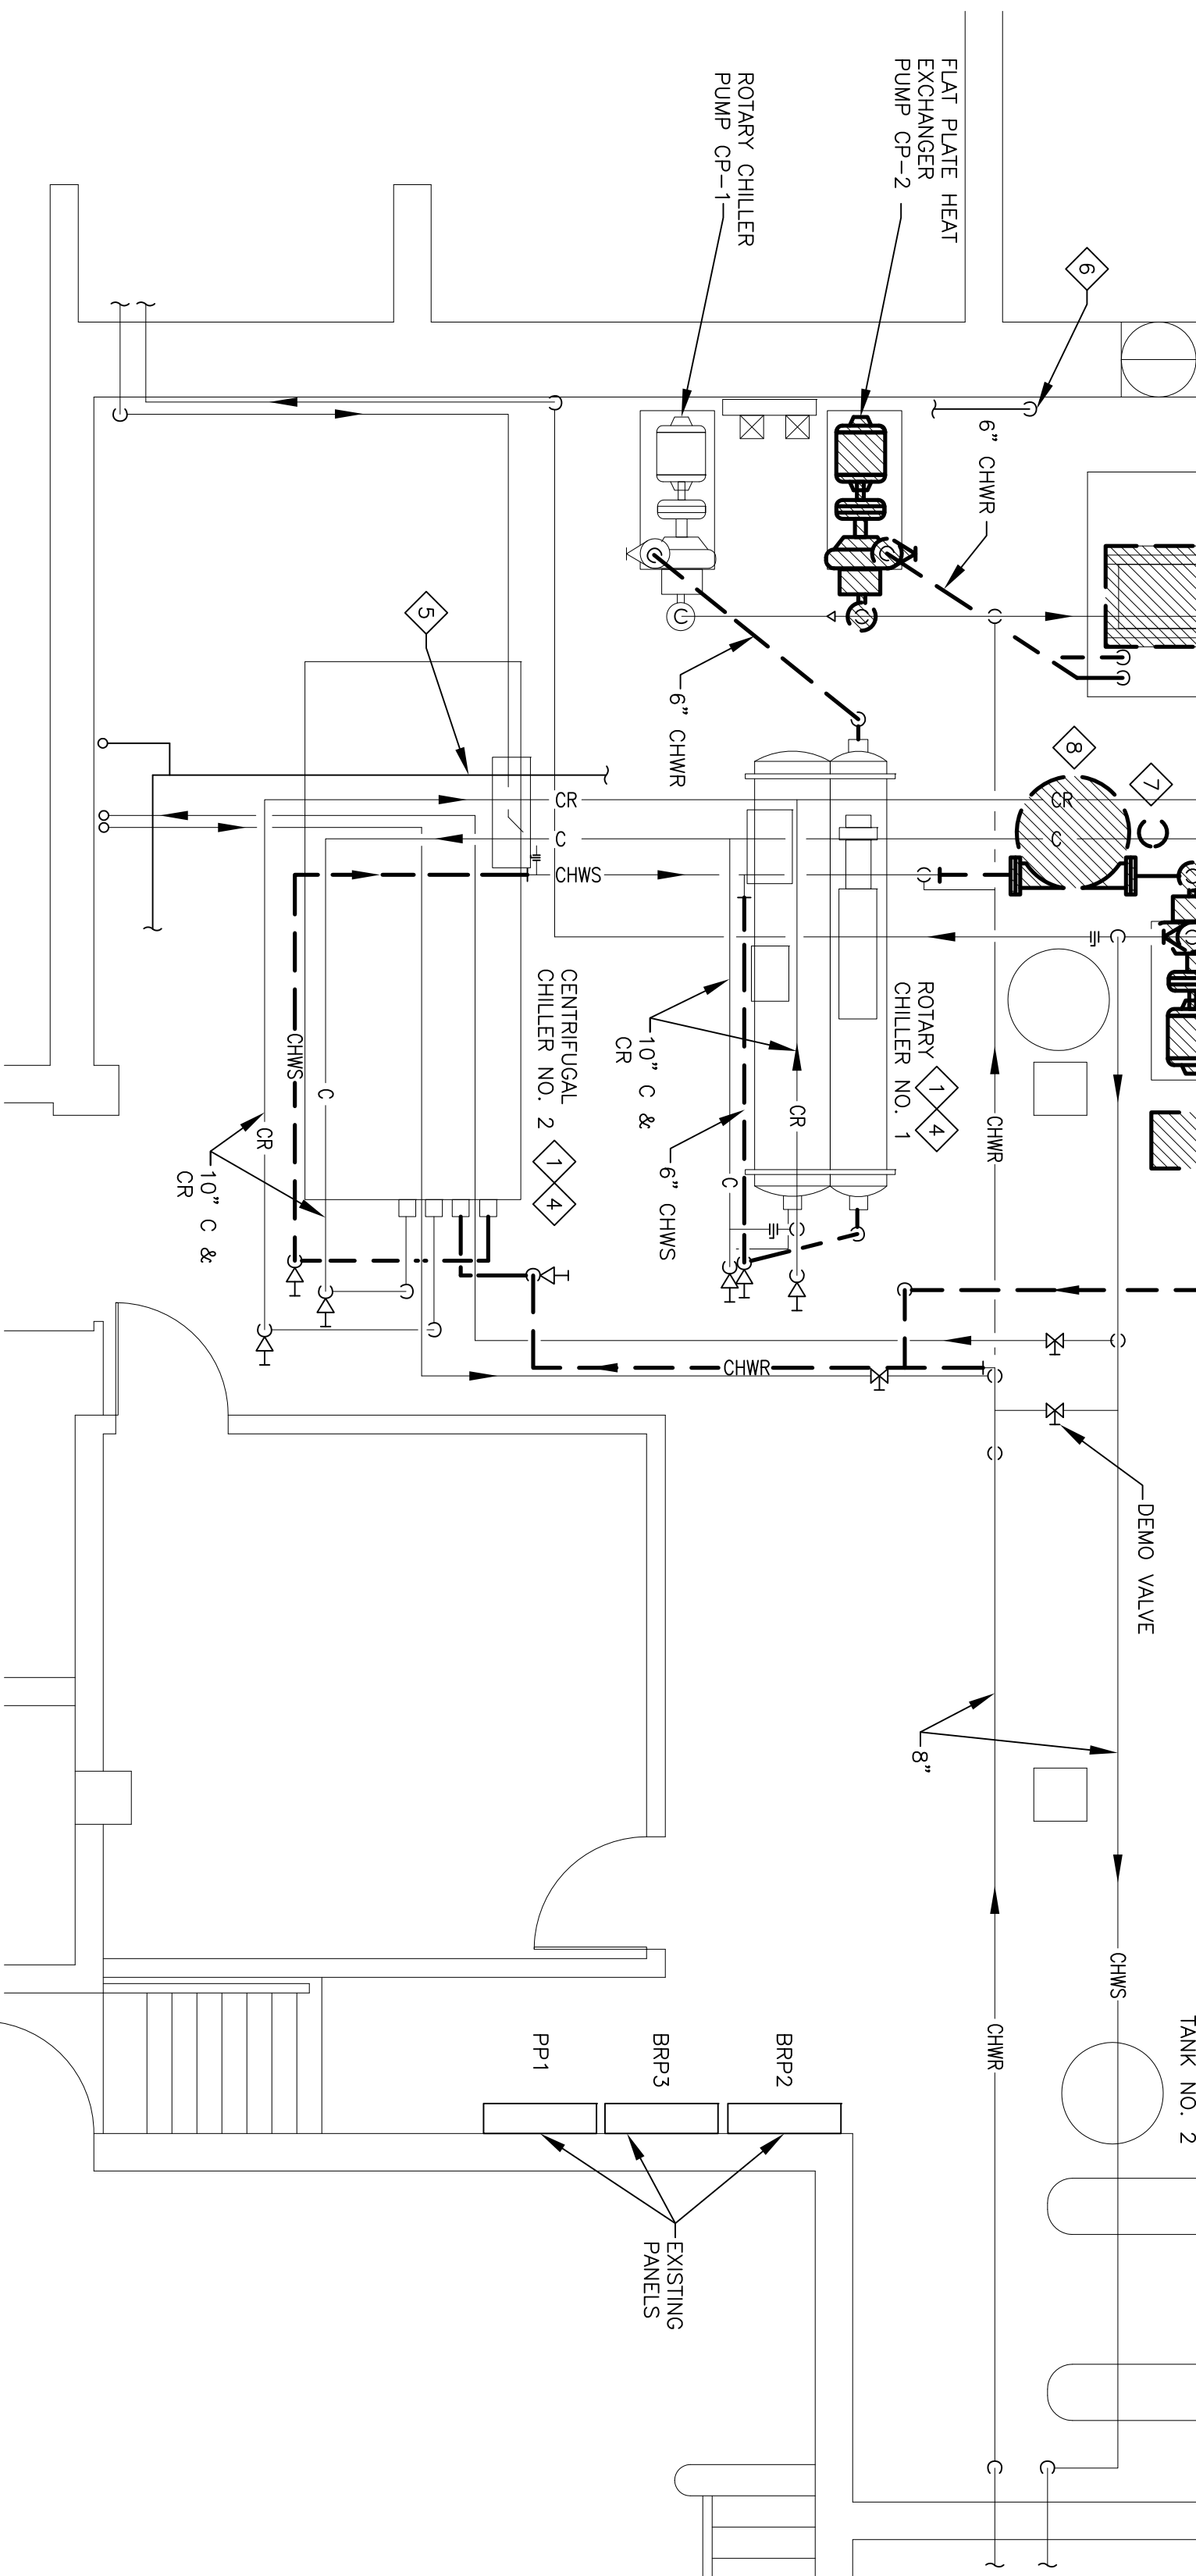

- MO E-30125

ENG  
BEEN  
THE  
SMo.  
R TAK  
R THE  
ONLY,  
ALL I  
CT DR  
THIS

- |     |                  |   |
|-----|------------------|---|
|     |                  | THE PROFESSIONAL ENGINEER'S SEAL IS REQUIRED ON THIS DRAWING HAS BEEN PLACED IN ACCORDANCE WITH THE REQUIREMENTS OF CHAPTER 327, F.S. |
|     |                  | SEAL THE ENGINEER'S NAME AND RESPONSIBILITY FOR THE DESIGN OF THE PROJECT ON THIS DRAWING.  |
|     |                  | DISCLAIMS ANY AND ALL LIABILITY FOR OTHER PROJECTS NOT SHOWN ON THIS DRAWING.   |
| 4/6 | CHECKED BY: H.S. | DIRECTOR: Y. BEARIN   |

THE PROFESSIONAL ENGINEER'S SEAL ON THIS DRAWING HAS BEEN AFFIXED IN ACCORDANCE WITH THE REQUIREMENTS OF CHAPTER 327, RSMo. IN AFFIXING THIS SEAL THE ENGINEER TAKES RESPONSIBILITY FOR THE WORK SHOWN ON THIS DRAWING ONLY, AND HEREBY DISCLAIMS ANY AND ALL RESPONSIBILITY FOR OTHER PROJECT DRAWINGS NOT DIRECTLY RELATING TO THIS SEAL.

KRAIG L. SPENCE, P.E.  
MO E-30125

DRAWN BY K/S	CHECKED BY K/S	

**Project Solutions**  
Engineering, Inc.

2005 West Broadway • Suite 210 • Columbia • MO 65203  
• Phone: (573) 443-7100 • Fax: (573) 443-7181 •

MIZZOU NORTH - REPLACE CHILLER  
COLUMBIA, BOONE COUNTY, MISSOURI 65203

# MECHANICAL DEMOLITION PLAN

PROJECT NUMBER  
CP131791

M101 SHEET