

MIZZOU NORTH REPLACE CHILLER

MU PROJECT No. CP131791

UNIVERSITY OF MISSOURI

FOR THE CURATORS OF THE UNIVERSITY OF MISSOURI
COLUMBIA, MISSOURI




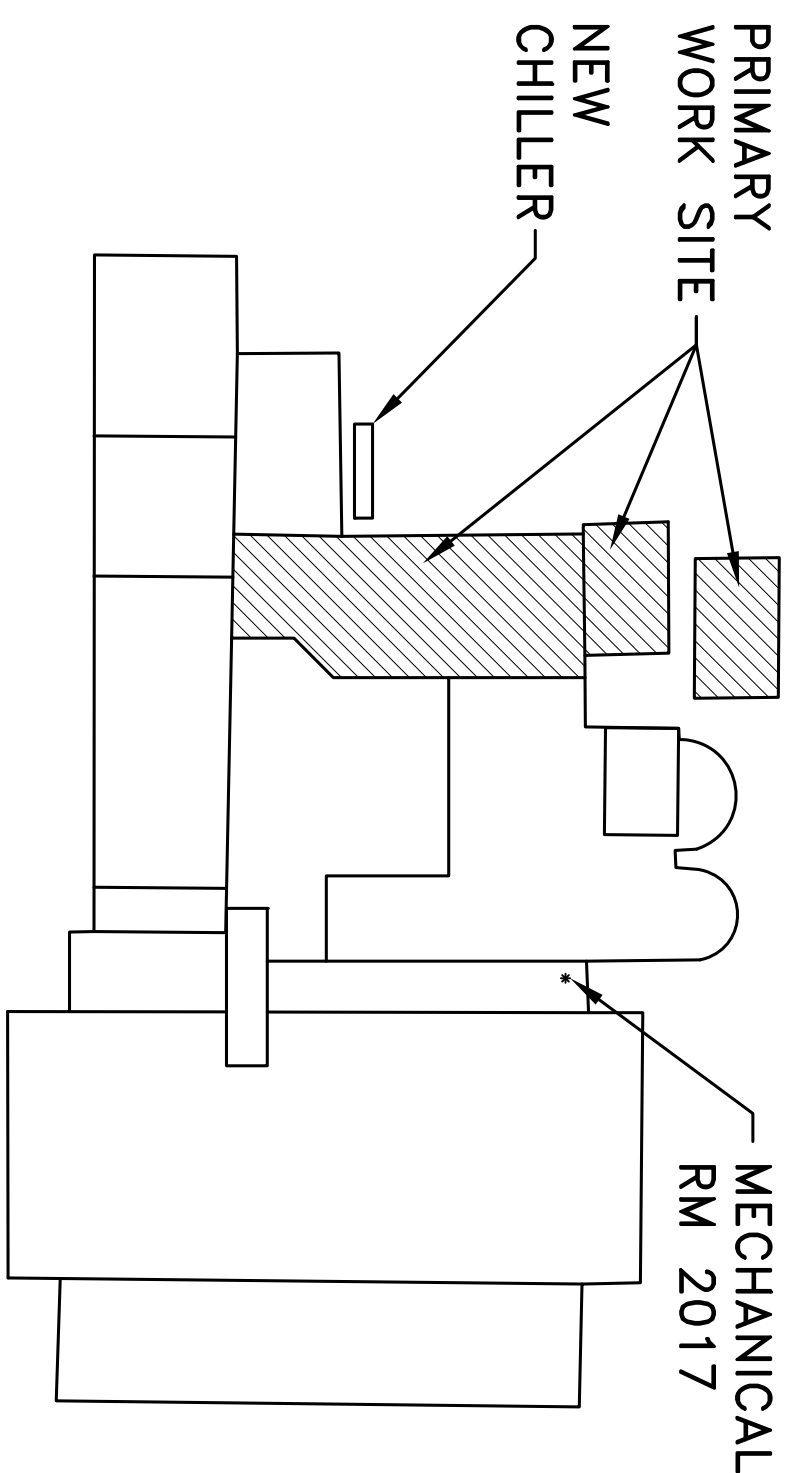
**Issued for Bid:
DECEMBER 30, 2013**

PREPARED BY:




2005 West Broadway • Suite 210
Columbia • MO 65203
Phone: (573) 443-7100
Fax: (573) 443-7181

DRAWING INDEX	
DWG. NO.	SHEET TITLE
G001	TITLE SHEET
M101	MECHANICAL DEMOLITION PLAN
M102	MECHANICAL RENOVATION PLAN
M501	MECHANICAL SCHEDULES AND DETAILS
M502	MECHANICAL CONTROLS
M503	MECHANICAL CONTROLS
E101	ELECTRICAL DEMOLITION PLAN
E102	ELECTRICAL RENOVATION PLAN
E501	ELECTRICAL SCHEDULES AND DETAILS



PROJECT SITE MAP

SCALE: NONE

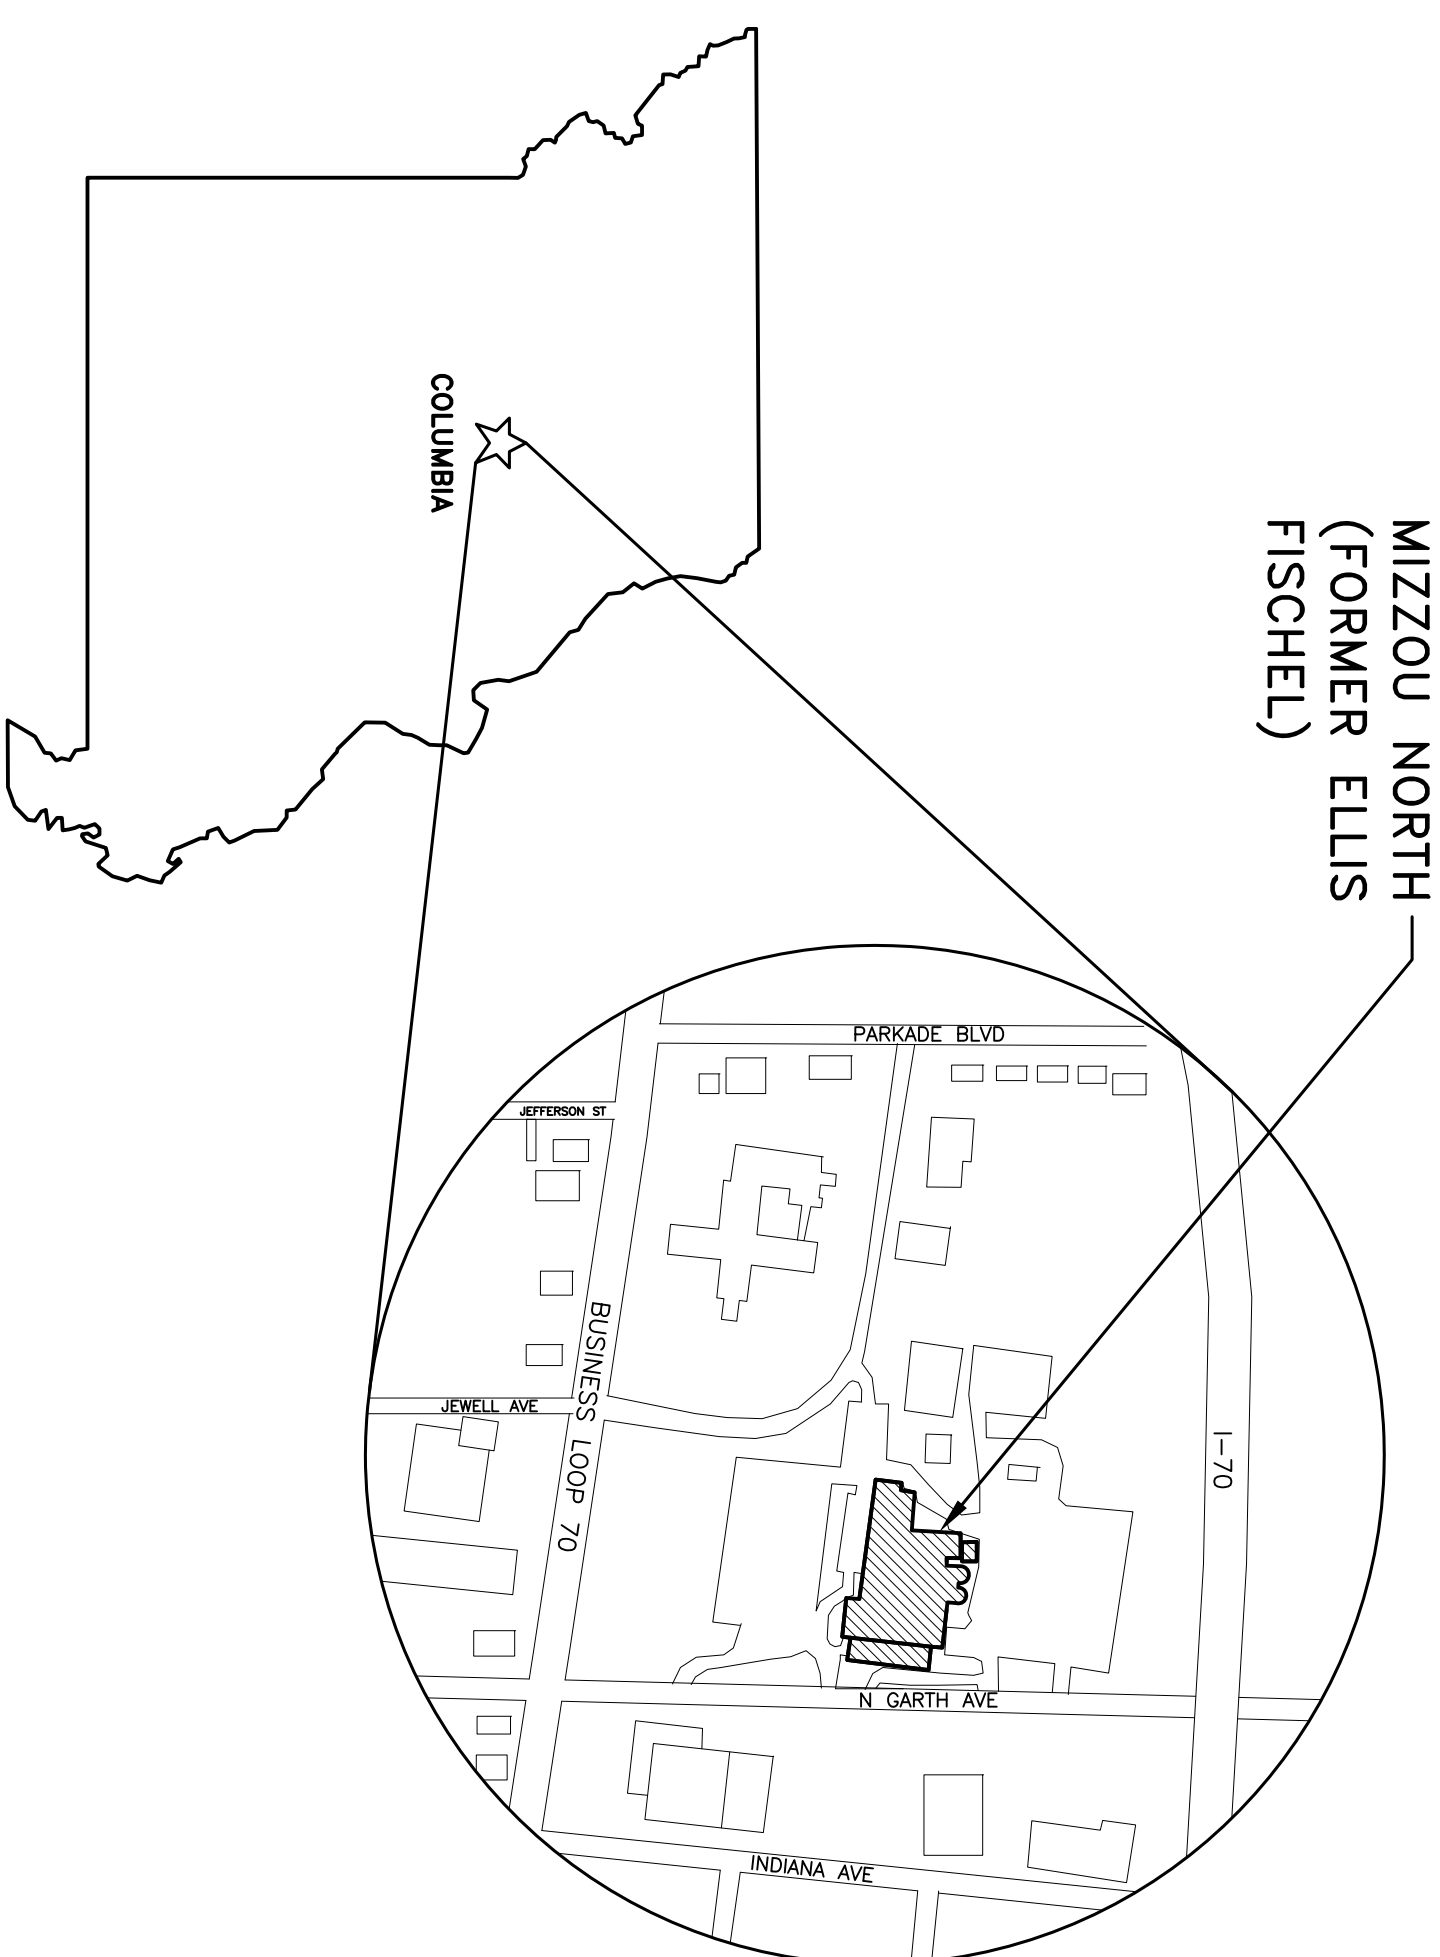

AS-BUILT DRAWINGS HAVE BEEN
MODIFIED PER CONTRACTOR
MARKUPS RECEIVED ON
05-19-14

KRAIG L. SPENCE, P.E.
MO E-30125

THE PROFESSIONAL ENGINEER'S SEAL ON
THIS DRAWING HAS BEEN AFFIXED IN
ACCORDANCE WITH THE REQUIREMENTS
OF CHAPTER 327, R.S.Mo. IN AFFIXING THIS
SEAL THE ENGINEER TAKES
RESPONSIBILITY FOR THE WORK SHOWN
ON THIS DRAWING ONLY, AND HEREBY
DISCLAIMS ANY AND ALL RESPONSIBILITY
FOR OTHER PROJECT DRAWINGS NOT
DIRECTLY BEARING THIS SEAL

DRAWN BY: _____ CHECKED BY: _____

2005 West Broadway • Suite 210 • Columbia • MO 65203
• Phone: (573) 443-7100 • Fax: (573) 443-7181 •

PSE Project E1329.01

MIZZOU NORTH - REPLACE CHILLER
COLUMBIA, BOONE COUNTY, MISSOURI 65203

TITLE SHEET

PROJECT NUMBER

CP131791

SHEET

GOO1
1 of 3