


AS-BUILT DRAWINGS HAVE BEEN
MODIFIED PER CONTRACTOR
MARKINGS REQUIRED ON

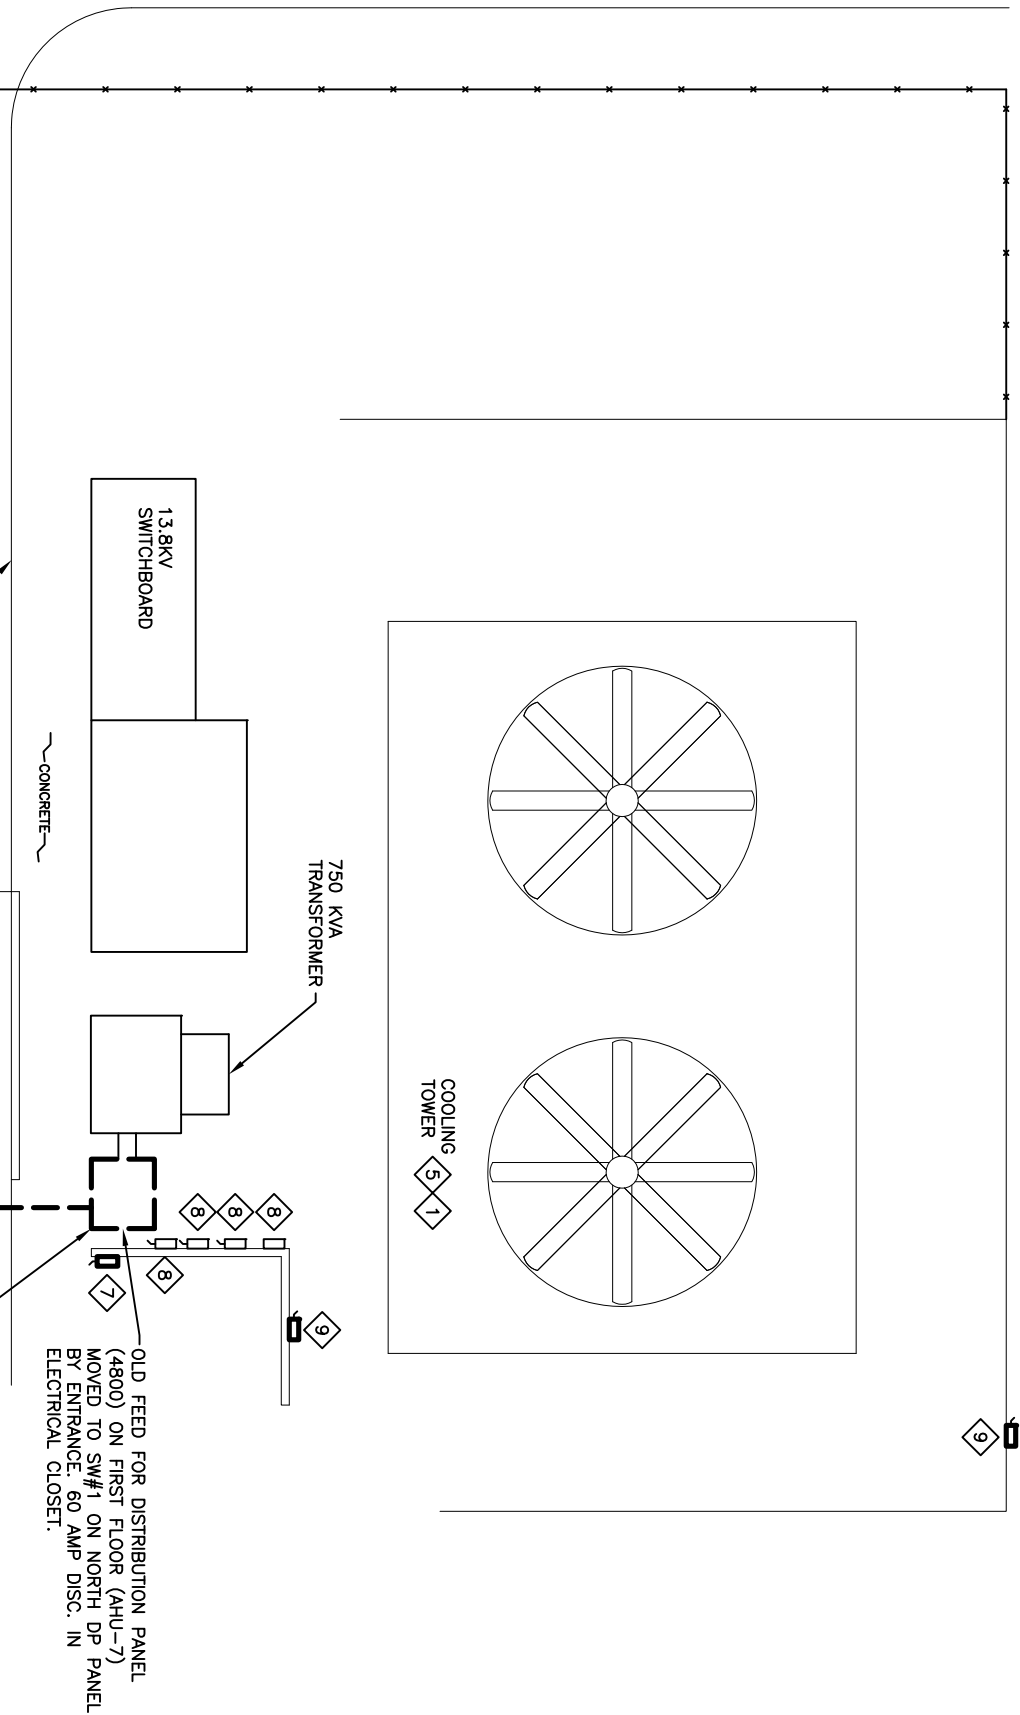

6 UNDER ALTERNATE #2 EQUIPMENT TO BE REMOVED. DEMOLISH


EQUIPMENT BACK TO 480V PULL BOX. COORDINATE FOR POSSIBLE RE-USE OF CONDUIT

7 DEMO 60A SWITCH AND FLEX CONDUIT

8 SWITCHES, FLEX CONDUIT AND 3.0 KVA TRANSFORMER TO REMAIN.

9 DEMO 200A SWITCH AND FLEX CONDUIT

10 EITHER EXISTING CHILLER FEED CONDUIT (BUT NOT BOTH) AVAILABLE FOR RE-USE TO FEED NEW PUMP. #1 FLEX CONDUIT USED TO RUN NEW PUMP. REMAINING NEW CONDUITS MUST MATCH ROUTE OF EXISTING CONDUIT TO RUN IN PARALLEL.

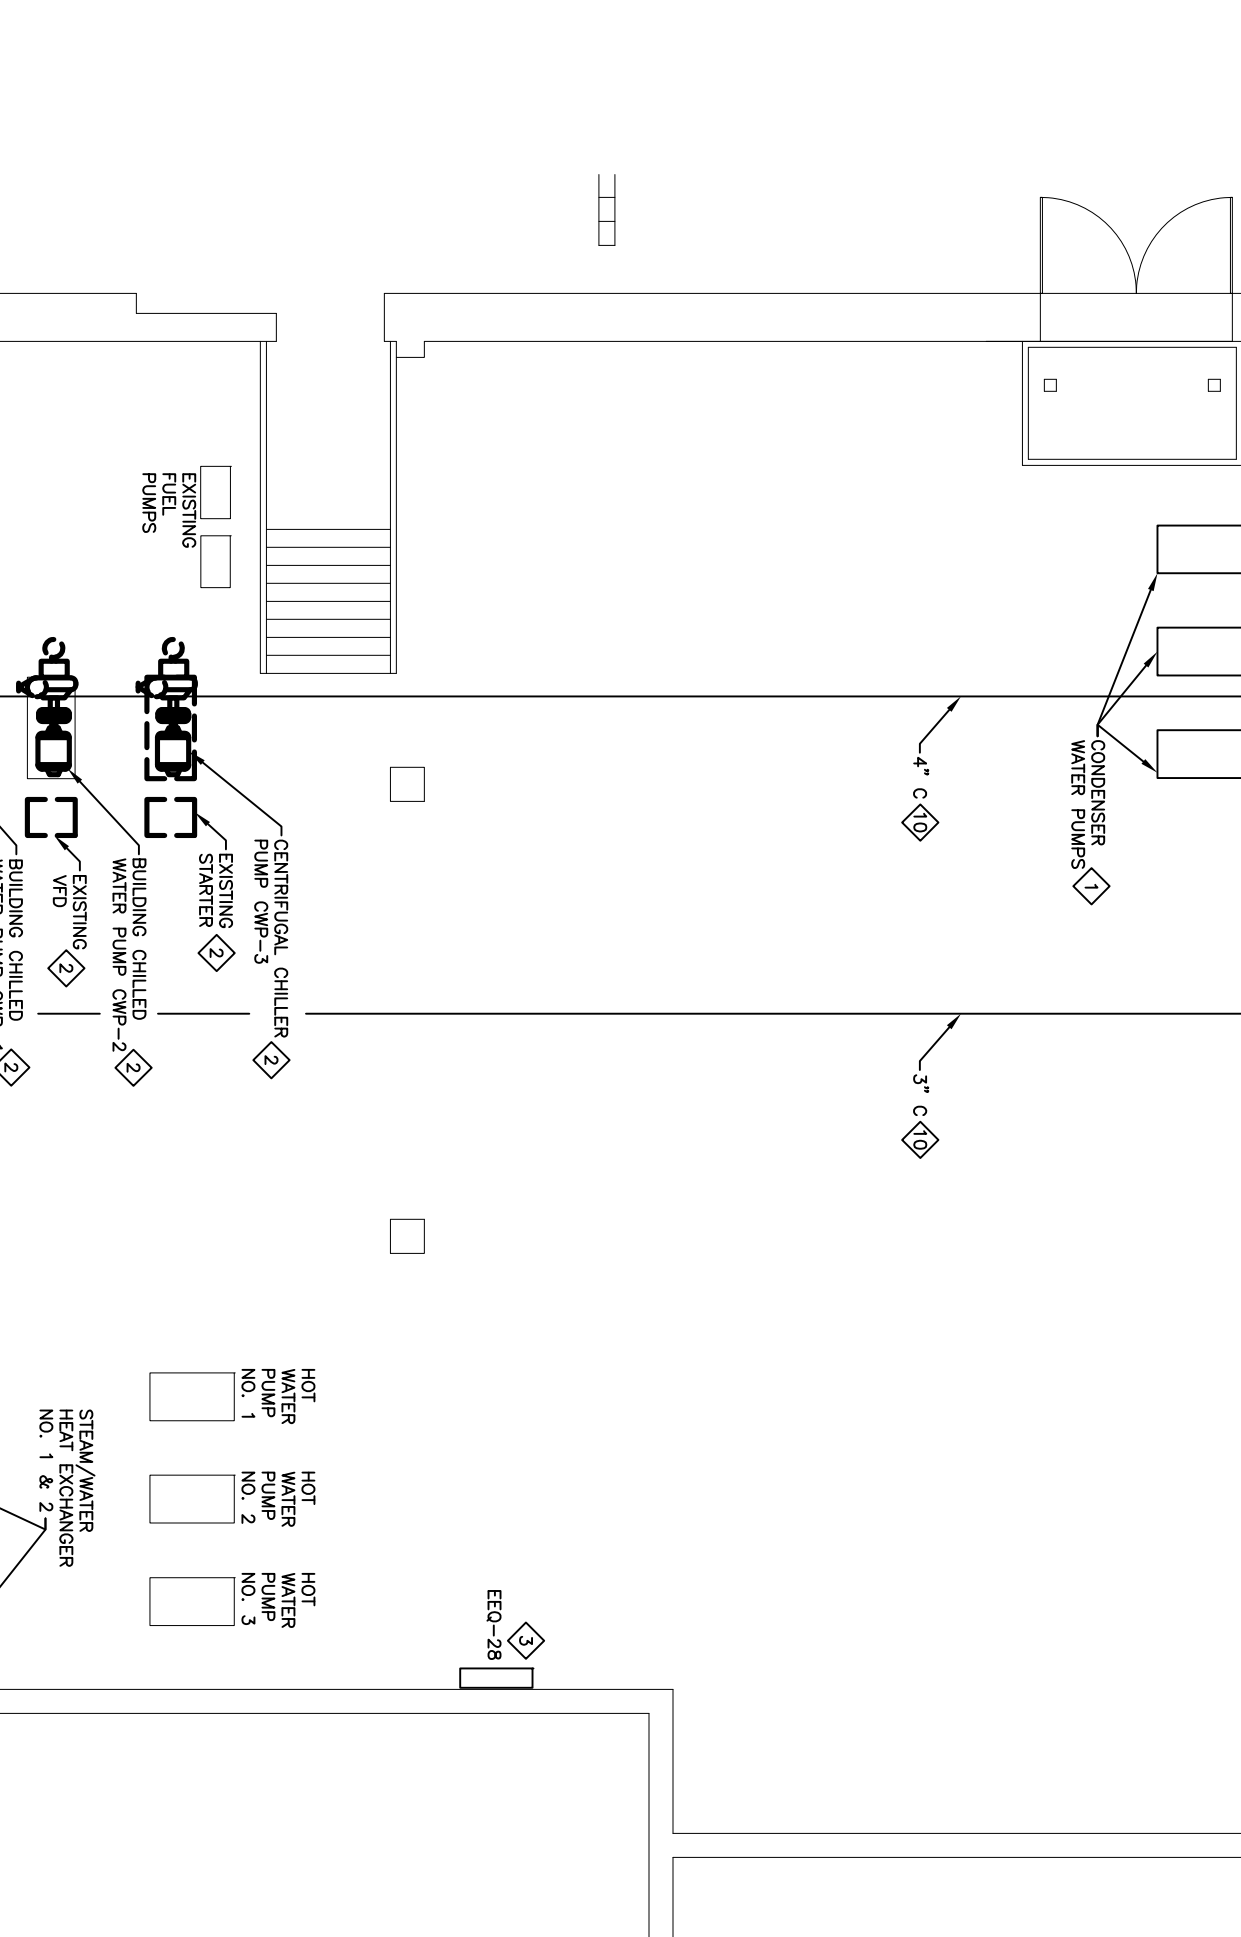[illegible]

MO E-30125

L ENG
 BEEN
 I THE
 S Mo.
 R TAK
 R TH
 ONLY
 O ALL
 CT DR
 THIS

- | | | |
|--|-------------------|---|
| | | THE PROFESSIONAL ENGINEER HAS REVIEWED THIS DRAWING HAS BEEN PREPARED IN ACCORDANCE WITH THE REQUIREMENTS OF CHAPTER 327, F.S. THE ENGINEER ASSUMES NO RESPONSIBILITY FOR THE ACCURACY OF THE INFORMATION ON THIS DRAWING. THE ENGINEER DOES NOT DISCLAIM ANY AND ACCEPTS NO LIABILITY FOR OTHER PROJECTS OR DIRECTLY RELATED PROJECTS. |
| IN WITNESS WHEREOF, I have hereunto set my hand and the seal of the State of Florida, this _____ day of _____, 20____. | CHECKED BY: _____ | |

THE PROFESSIONAL ENGINEER'S SEAL ON THIS DRAWING HAS BEEN AFFIXED IN ACCORDANCE WITH THE REQUIREMENTS OF CHAPTER 327, RSMo. IN AFFIXING THIS SEAL THE ENGINEER TAKES RESPONSIBILITY FOR THE WORK SHOWN ON THIS DRAWING ONLY, AND HEREBY DISCLAIMS ANY AND ALL RESPONSIBILITY FOR OTHER PROJECT DRAWINGS NOT DIRECTLY BEARING THIS SEAL.

Project Solutions
Engineering, Inc.

2005 West Broadway • Suite 210 • Columbia • MO 65203
• Phone: (573) 443-7100 • Fax: (573) 443-7181 •

PSE Project E1329.01

MIZZOU NORTH - REPLACE CHILLER
COLUMBIA, BOONE COUNTY, MISSOURI 65203

ELECTRICAL DEMOLITION PLAN

PROJECT NUMBER
CP131791

E101